



GT



STEVEN VESTERGAARD

LICENCE OF OCCUPATION APPLICATION MAPPING PACKAGE

BATTANI CREEK

DRAWING INDEX


VES51-GA0V-01	GENERAL ARRANGEMENT PLAN-LOO OVERVIEW MAP
VES51-GAV_AREAS 1 AND 2	GENERAL ARRANGEMENT PLAN-LOO AREAS 1 AND 2 MAP
VES51-GAV_AREA 3	GENERAL ARRANGEMENT PLAN-LOO AREA 3 MAP
VES51-GAV_AREA 4	GENERAL ARRANGEMENT PLAN-LOO AREA 4 MAP
VES51-GAV_AREA 5	GENERAL ARRANGEMENT PLAN-LOO AREA 5 MAP

Licence Of Occupation Map Disclaimer

The underlying (gravel out) topographic, as built survey information and the delineation of various property boundaries (unless noted) was provided by Bennett Land Surveying Ltd. through John M. Franko, B.C.L.S.


Additional, as built topographic survey information, collected by JCH Forestry Ltd. (JCH) in 2014/15 on behalf of Steven Vestergaard for the purpose of a Licence of Occupation application is indicated in bold.

The dashed property lines are indicated for reference purposes only; they were not established by legal survey and are not marked in the field.

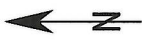

APPROXIMATE LOCATION OF EAST BOUNDARY OF L.L. (NOT DETERMINED BY LEGAL SURVEY)

APPROXIMATE LOCATION OF NORTH BOUNDARY OF BL 2035 (NOT DETERMINED BY LEGAL SURVEY)

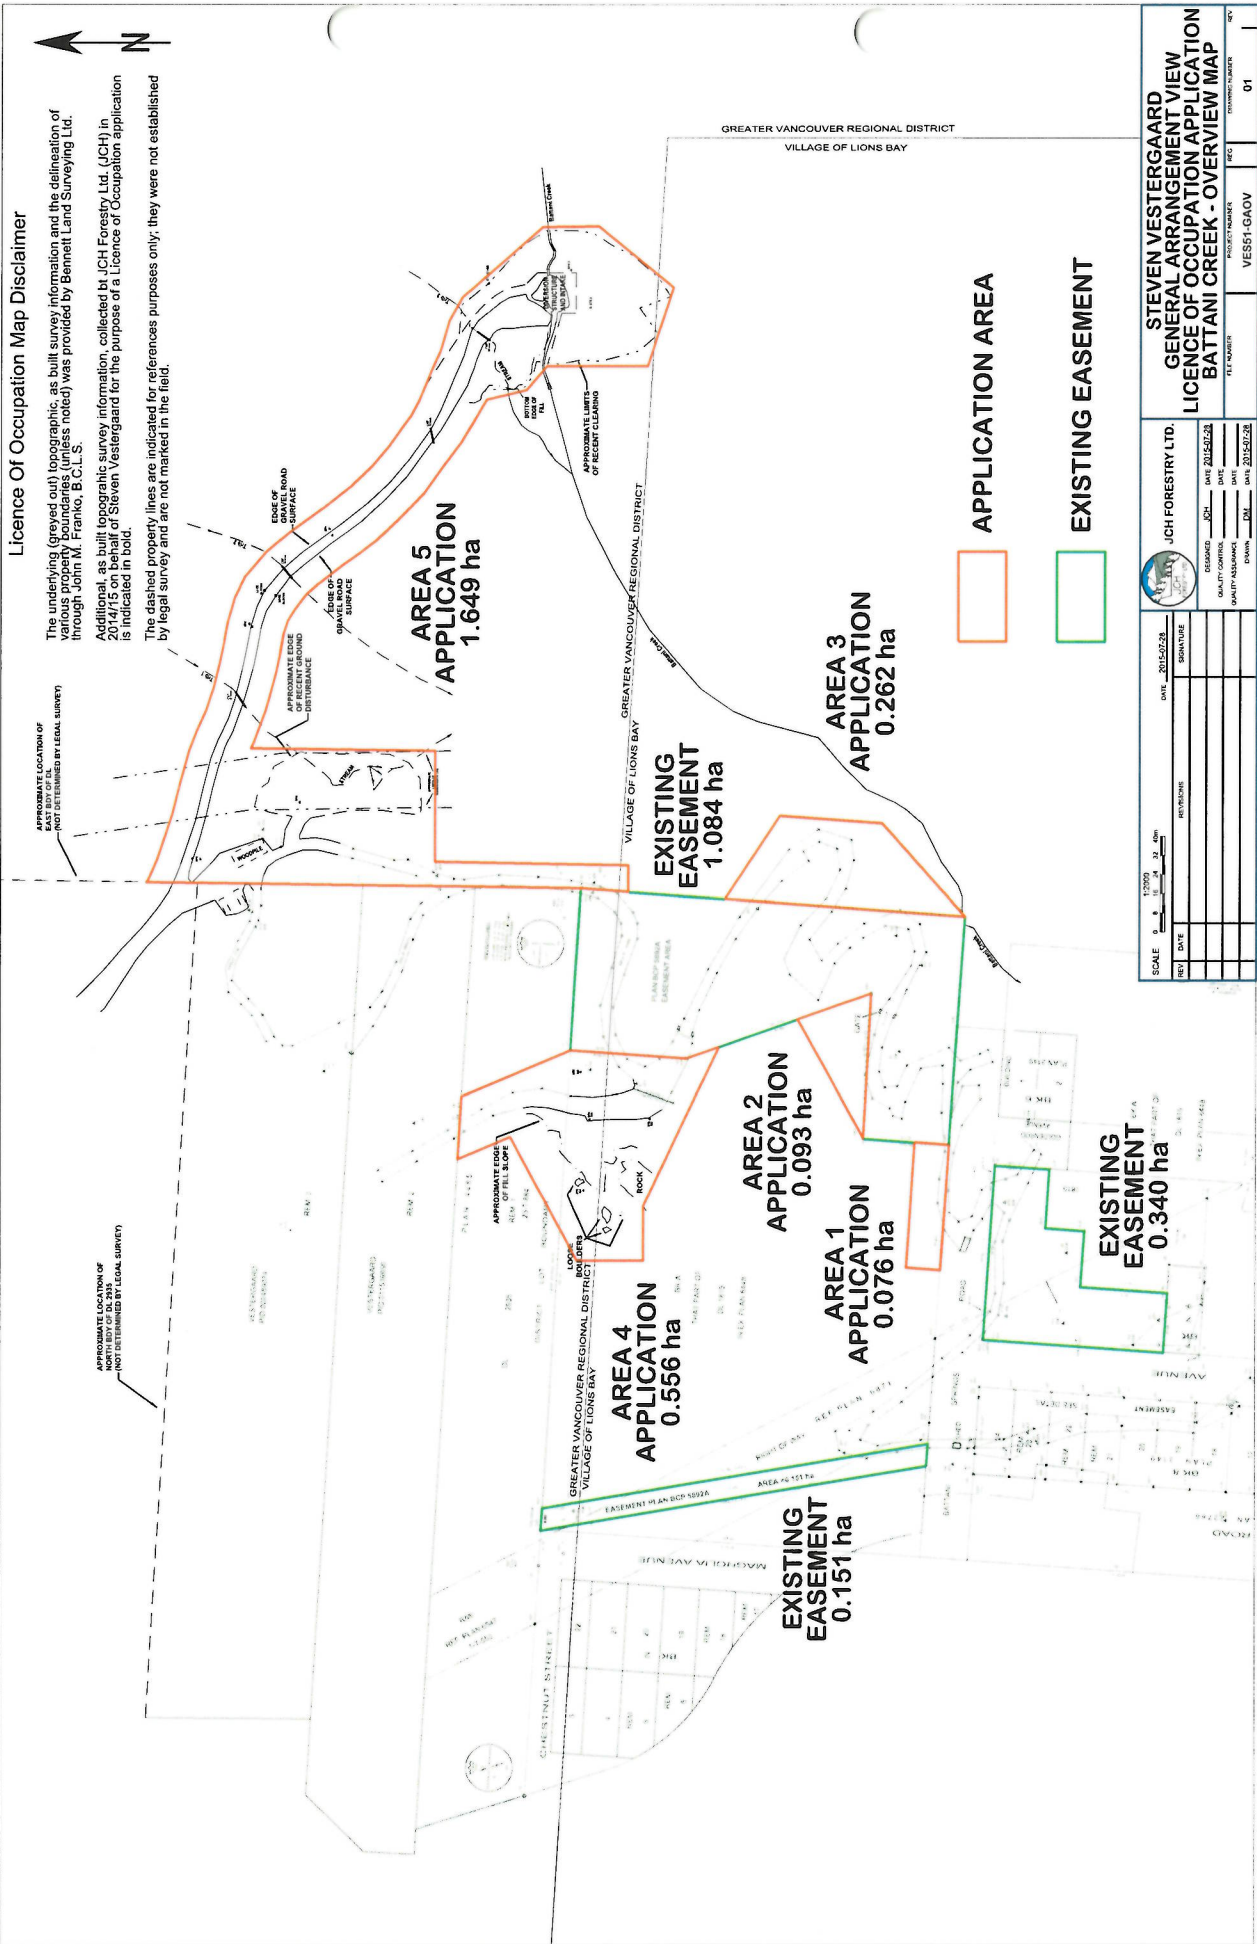

APPLICATION AREA

EXISTING EASEMENT

STEVEN VESTERGAARD GENERAL ARRANGEMENT VIEW LICENCE OF OCCUPATION APPLICATION BATTANI CREEK - OVERVIEW MAP		PROJECT NUMBER VES51-GA0V	SHEET 01
JCH FORESTRY LTD. ISSUED: JCH DATE: 2015/02/26 DRAWN: JCH DATE: 2015/02/26		SCALE: 1:10000 DATE: 2015/02/26 REV: DATE: SKETCH:	

Licence Of Occupation Map Disclaimer

The underlying (greyed out) topographic, as built survey information and the delineation of various property boundaries (unless noted) was provided by Bennett Land Surveying Ltd. through John M. Franko, B.C.L.S.

Additional, as built topographic survey information, collected by JCH Forestry Ltd. (JCH) in 2014/15 on behalf of Steven Vestergaard for the purpose of a Licence of Occupation application is indicated in bold.

The dashed property lines are indicated for references purposes only; they were not established by legal survey and are not marked in the field.

APPLICATION AREA


EXISTING EASEMENT

**AREA 2
EASEMENT
0.093 ha**

**AREA 1
EASEMENT
0.076 ha**

**EXISTING
EASEMENT
1.084 ha**

**EXISTING
EASEMENT
0.340 ha**

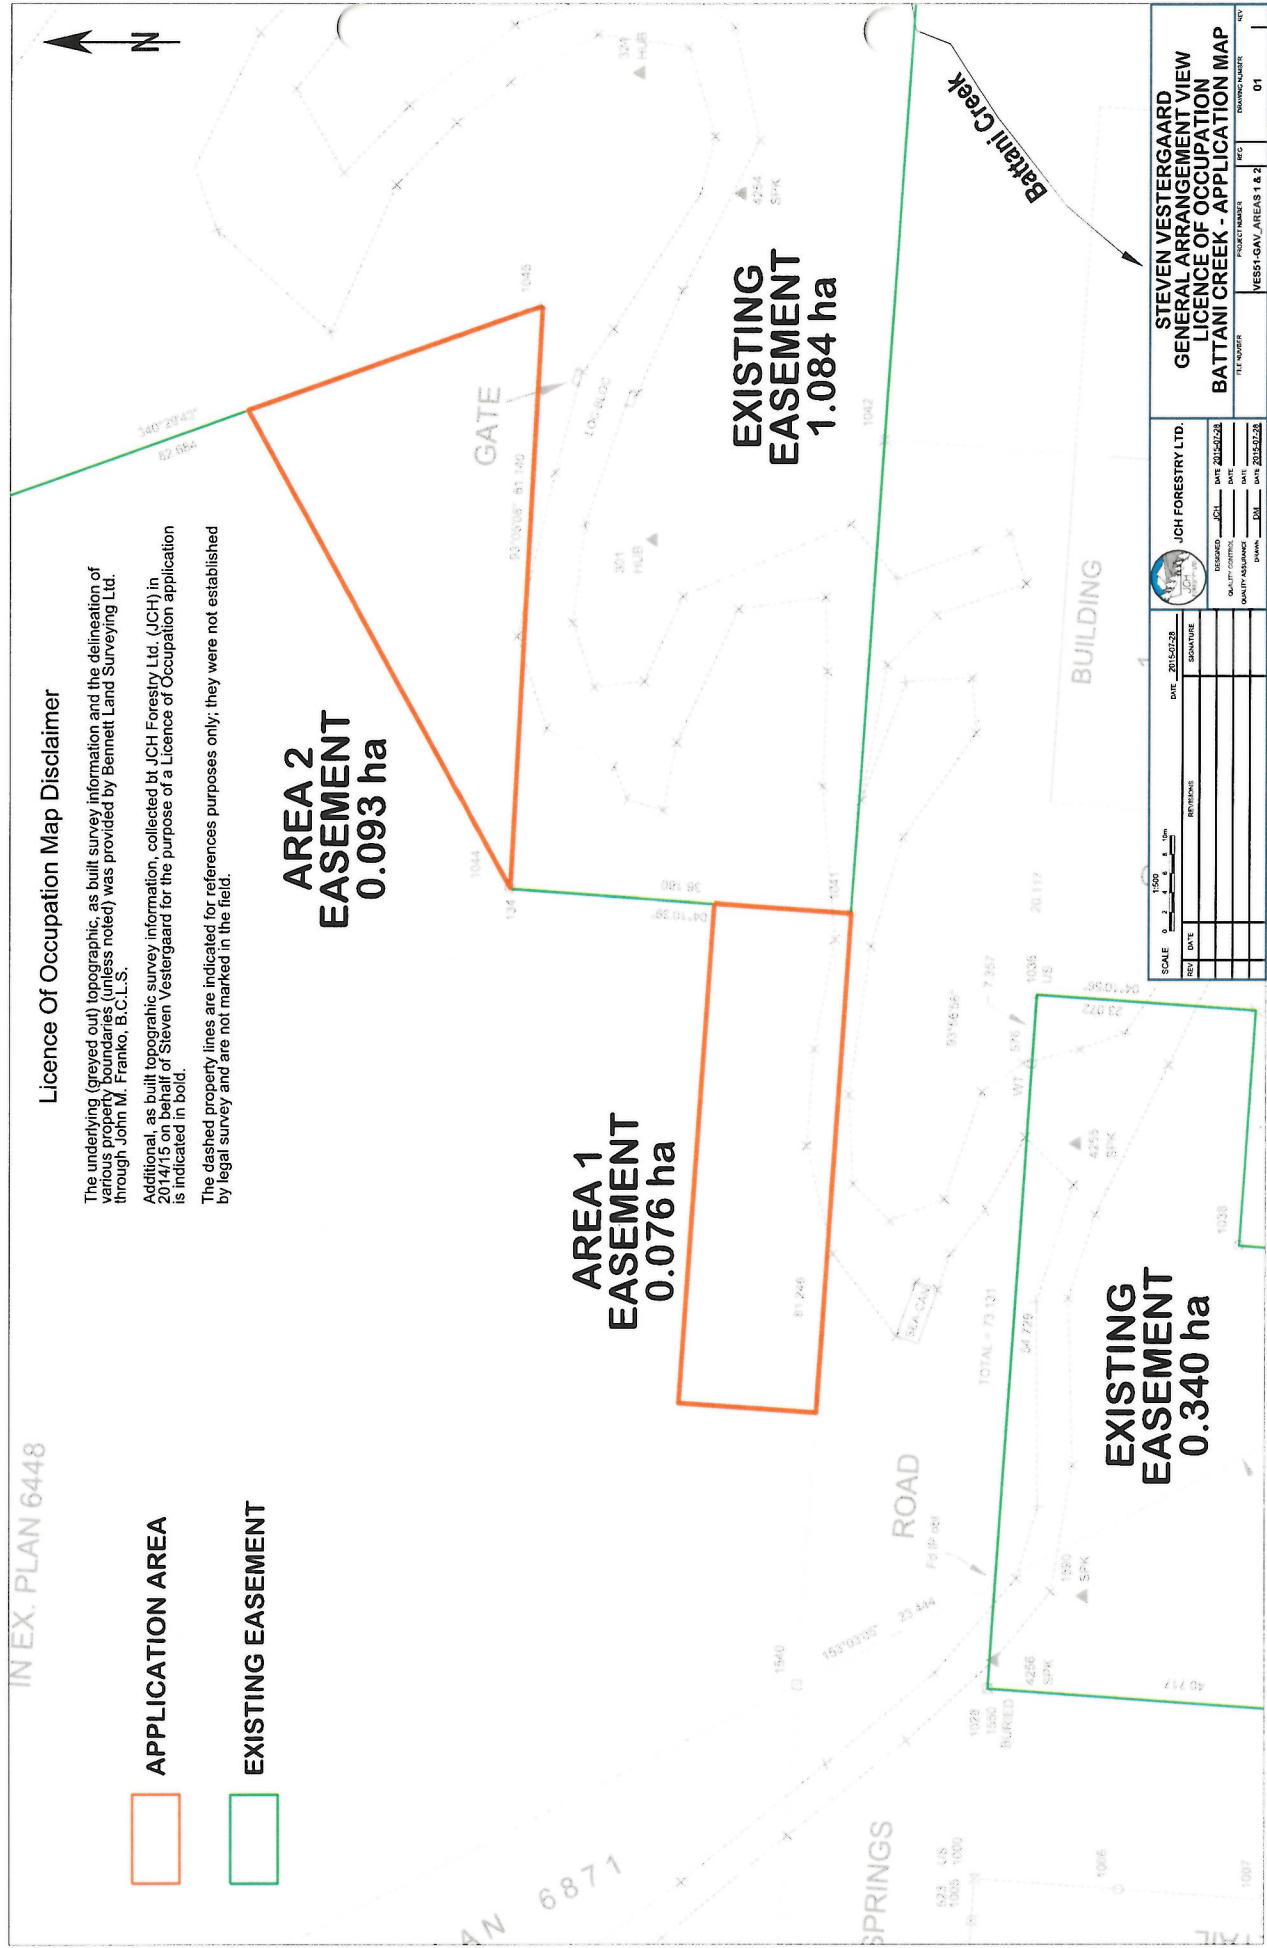

SCALE 1:500

DATE: 2015-07-28

NO. DATE

REVISION

SIGNATURE

JOH FORESTRY LTD.

ISSUANCE: 001

QUALITY CONTROL:

QUALITY ASSURANCE:

ISSUANCE:

DATE: 2015-07-28

DATE:

DATE: 2015-07-28

DATE: 2015-07-28

STEVEN VESTERGAARD GENERAL ARRANGEMENT VIEW LICENCE OF OCCUPATION BATTANI CREEK - APPLICATION MAP	FILE NUMBER	PROJECT NUMBER	REG	DRAWING NUMBER	REV
		VES51-GAV_AREAS 1 & 2		01	

APPLICATION AREA


EXISTING EASEMENT

Licence Of Occupation Map Disclaimer

The underlying (greyed out) topographic, as built survey information and the delineation of various property boundaries (unless noted) was provided by Bennett Land Surveying Ltd. through John M. Franko, B.C.L.S.

Additional, as built topographic survey information, collected by JCH Forestry Ltd. (JCH) in 2014/15 on behalf of Steven Vestergaard for the purpose of a Licence of Occupation application is indicated in bold.

The dashed property lines are indicated for reference purposes only; they were not established by legal survey and are not marked in the field.

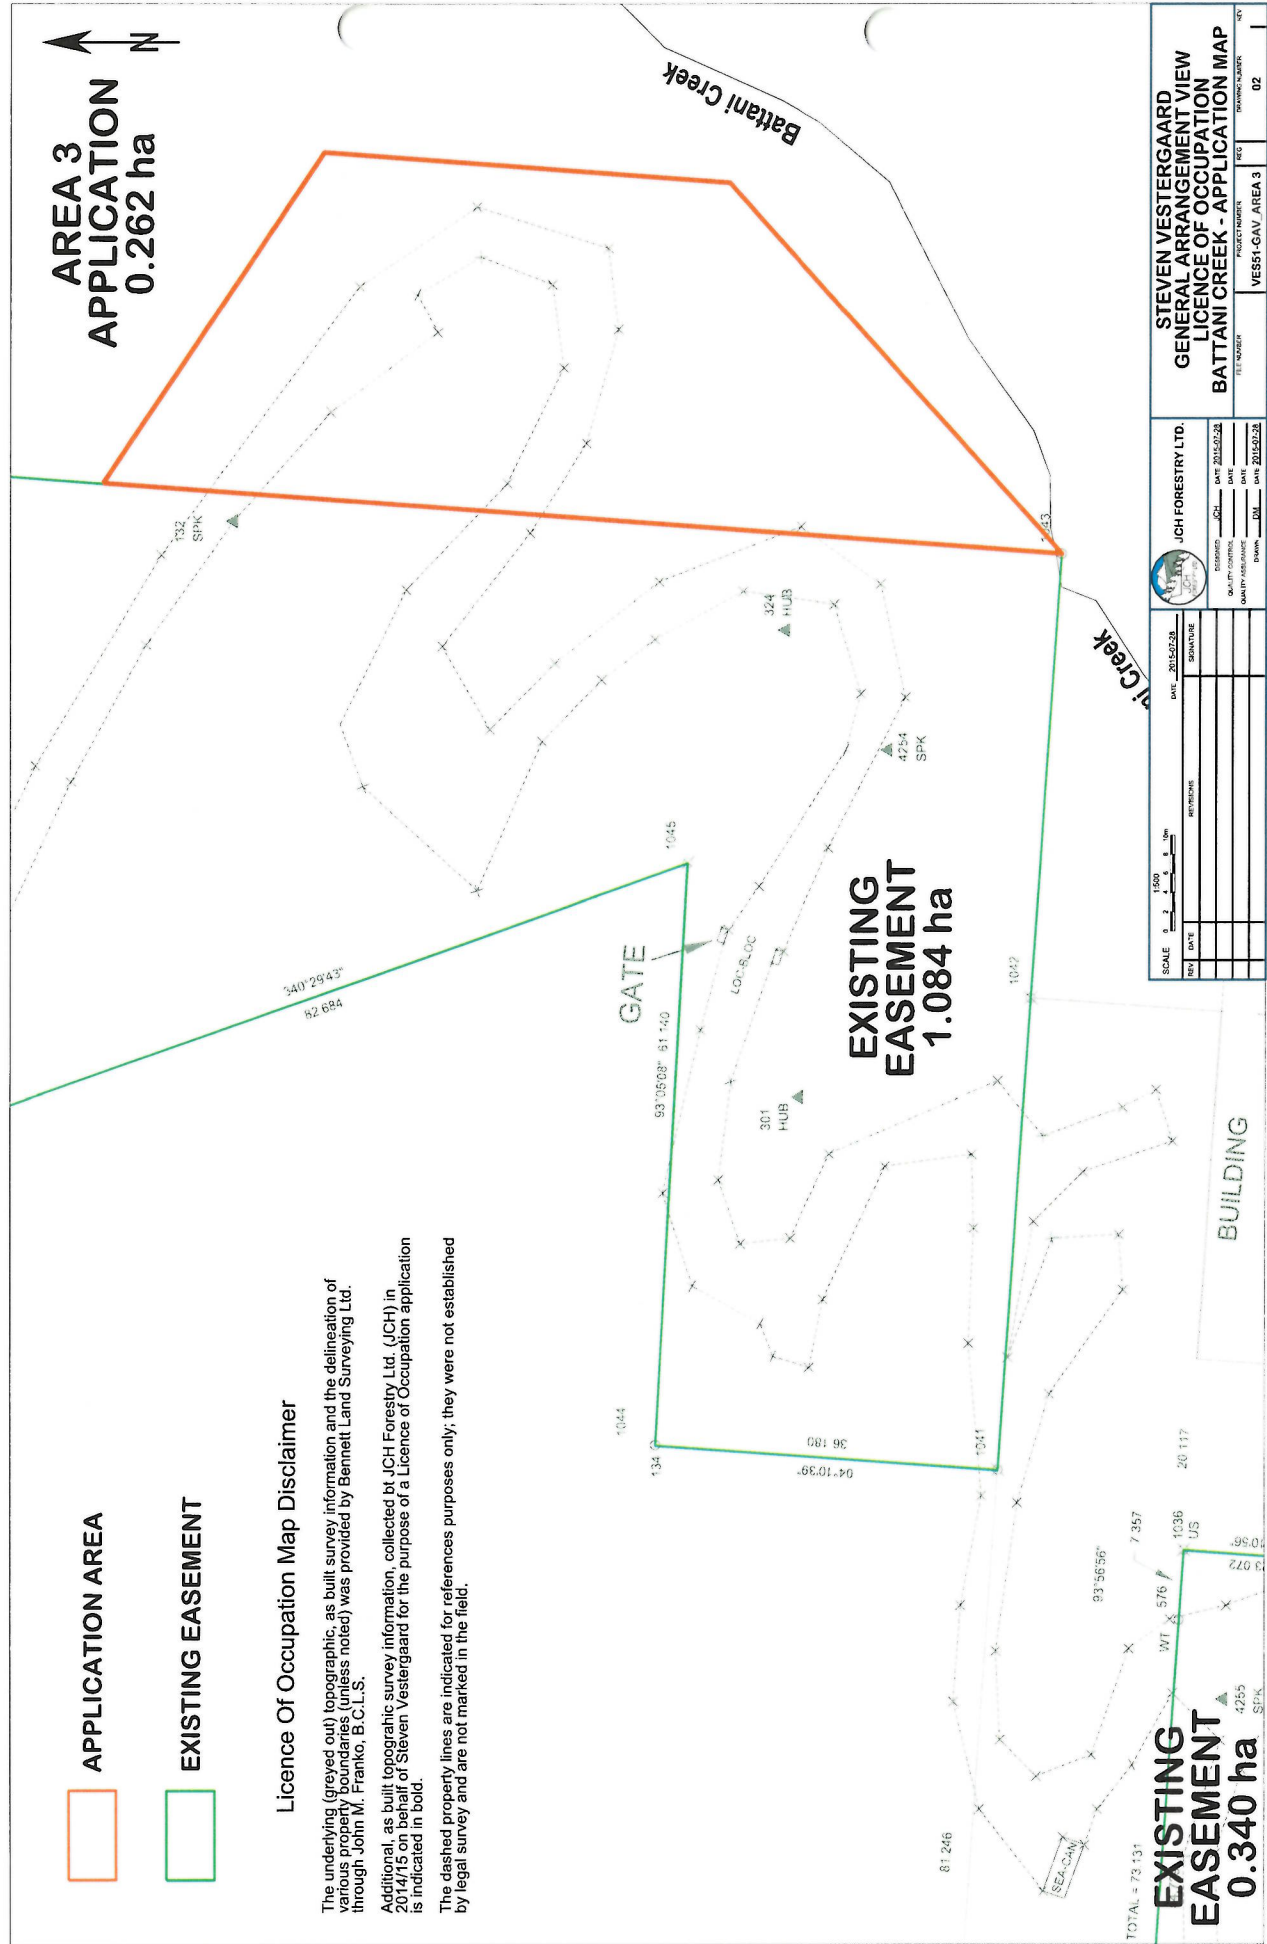


JCH FORESTRY LTD.		STEVEN VESTERGAARD	
DATE: 2015/02/28		GENERAL ARRANGEMENT VIEW	
REVISIONS		LICENCE OF OCCUPATION	
SIGNATURE		BATTANI CREEK - APPLICATION MAP	
DATE	DATE	PROJECT NUMBER	FILE NUMBER
		VES51-GAV_AREA 3	VES51-GAV_AREA 3
		REVISION	DRAWING NUMBER
			02

Licence Of Occupation Map Disclaimer

The underlying (greyed out) topographic, as built survey information and the delineation of various property boundaries (unless noted) was provided by Bennett Land Surveying Ltd. through John M. Franko, B.C.L.S.

Additional, as built topographic survey information, collected by JCH Forestry Ltd. (JCH) in 2014/15 on behalf of Steven Vestergaard for the purpose of a Licence of Occupation application is indicated in bold.

The dashed property lines are indicated for reference purposes only; they were not established by legal survey and are not marked in the field.

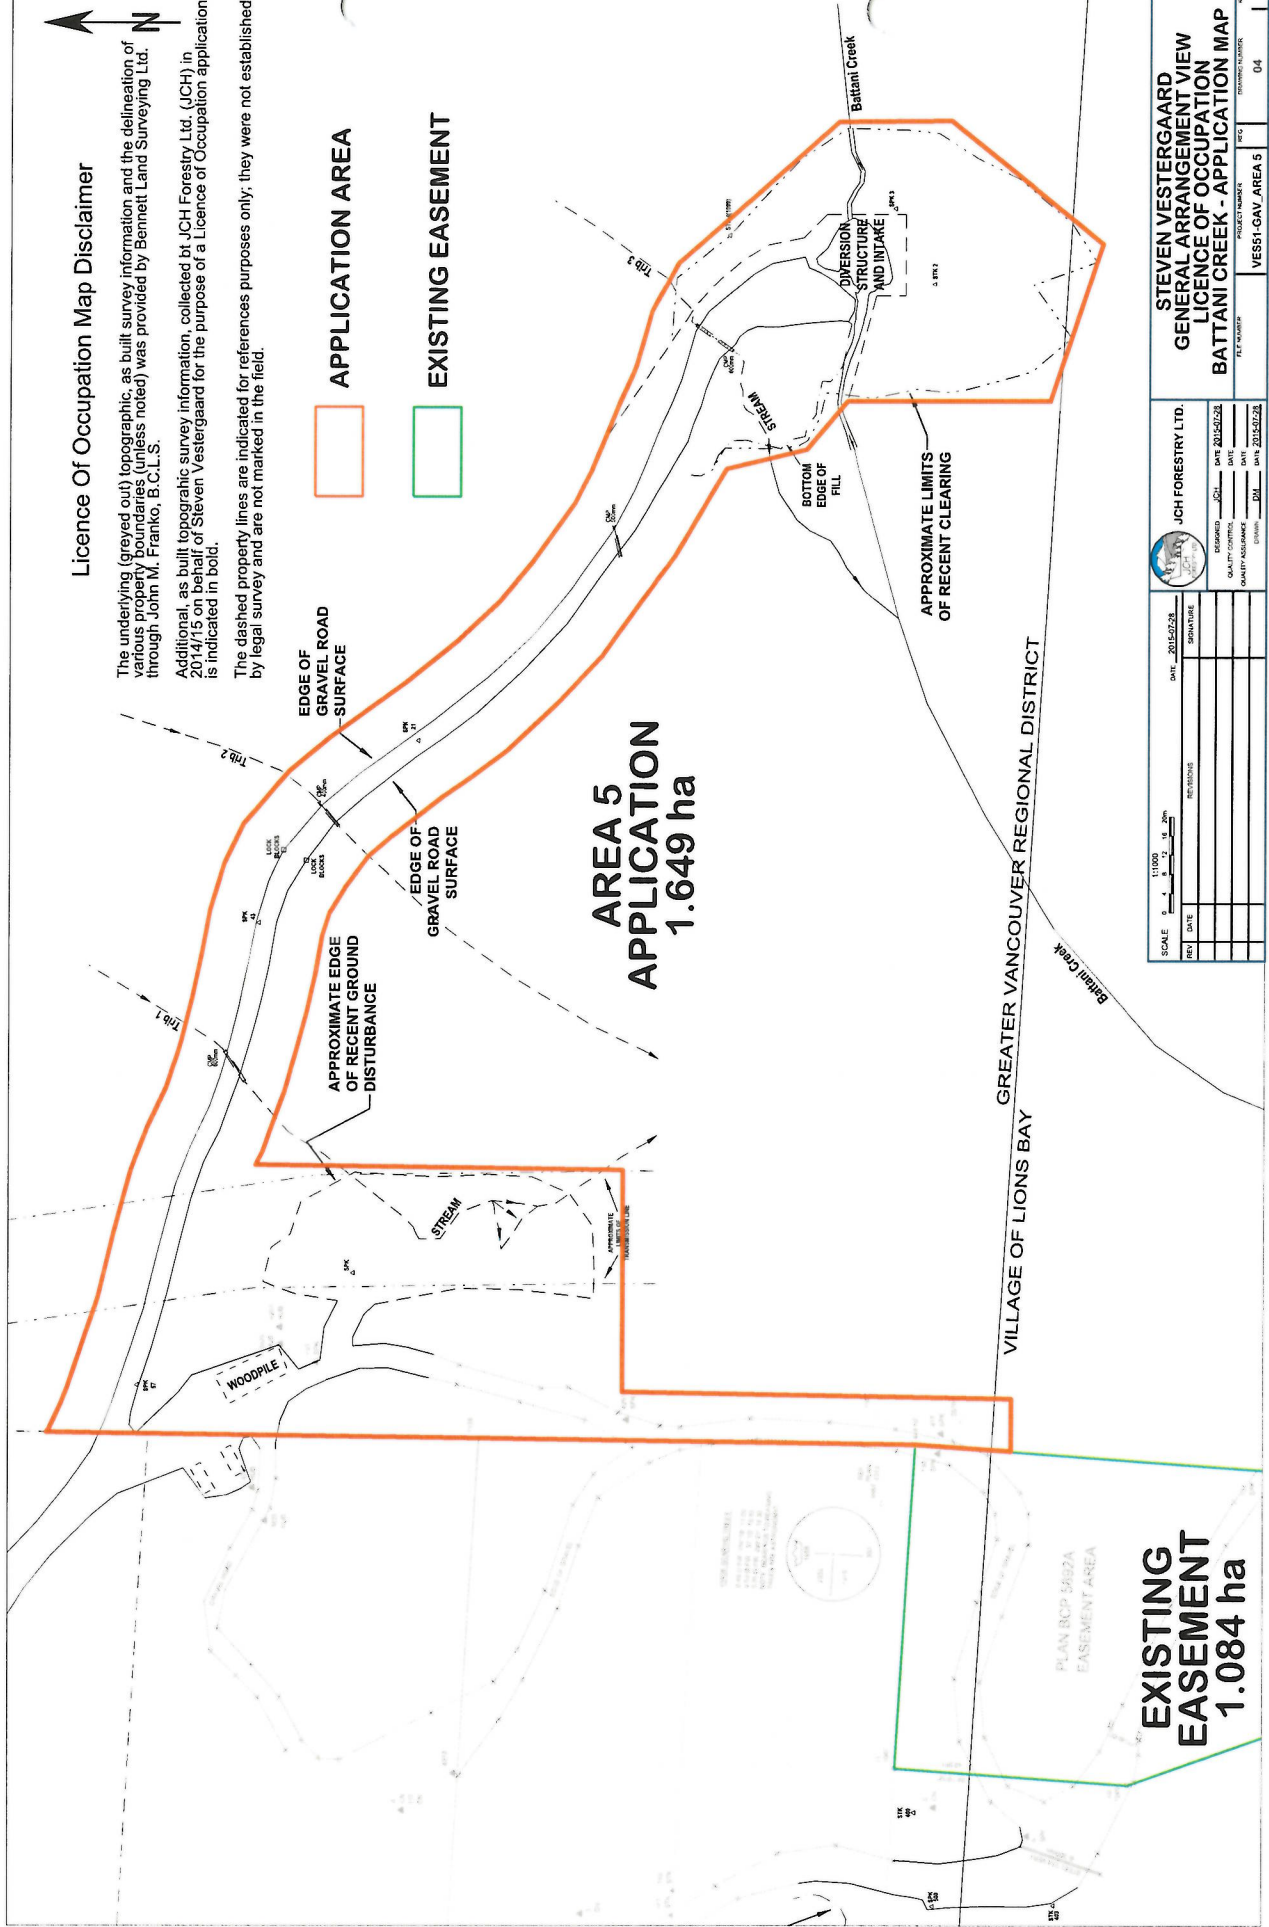

STEVEN VESTERGAARD GENERAL ARRANGEMENT VIEW LICENCE OF OCCUPATION BATTANI CREEK - APPLICATION MAP		JCH FORESTRY LTD. DESIGNED: JCH DATE: 2015/02/28 DRAWN: JCH DATE: 2015/02/28 CHECKED: JCH DATE: 2015/02/28 APPROVED: JCH DATE: 2015/02/28		PROJECT NUMBER: VES51-GAV AREA 5 SHEET NUMBER: 04
SCALE: 1:1000	DATE: 2015/02/28	SIGNATURE: _____ REVIEWING: _____ DATE: _____ DATE: _____ DATE: _____ DATE: _____		